

2m 3m 4m 5m 6m 7m 8m 9m 10m



1:100

Disclaimer:
 This plan is for layout guidance only. Not drawn to scale, unless stated.
 Measured & drawn to the nearest 15cm / 6 inches.
 Whilst every care is taken in the preparation of this plan, please check all dimensions, shapes & compass bearings before making any decisions reliant upon them.


The external elements that are shown are drawn to provide context but should not be used for any other purpose. Do not use this drawing to reference structure or mechanical services.

NOTES:
 · DO NOT SCALE FROM THIS DRAWING.
 · ALL DIMENSIONS TO BE CHECKED ON SITE.
 · ALL OMISSIONS AND DISCREPANCIES TO BE REPORTED TO THE ARCHITECT IMMEDIATELY

DRAWING TITLE		LEVEL -1_AS BUILTS GENERAL ARRANGEMENT_ANNOTATION PLAN			
DATE	01.2018	SCALE	1:100 @ A3	JOB NO.	449
DRWG NO.	AB.100	REV.			

2m 3m 4m 5m 6m 7m 8m 9m 10m

1:100

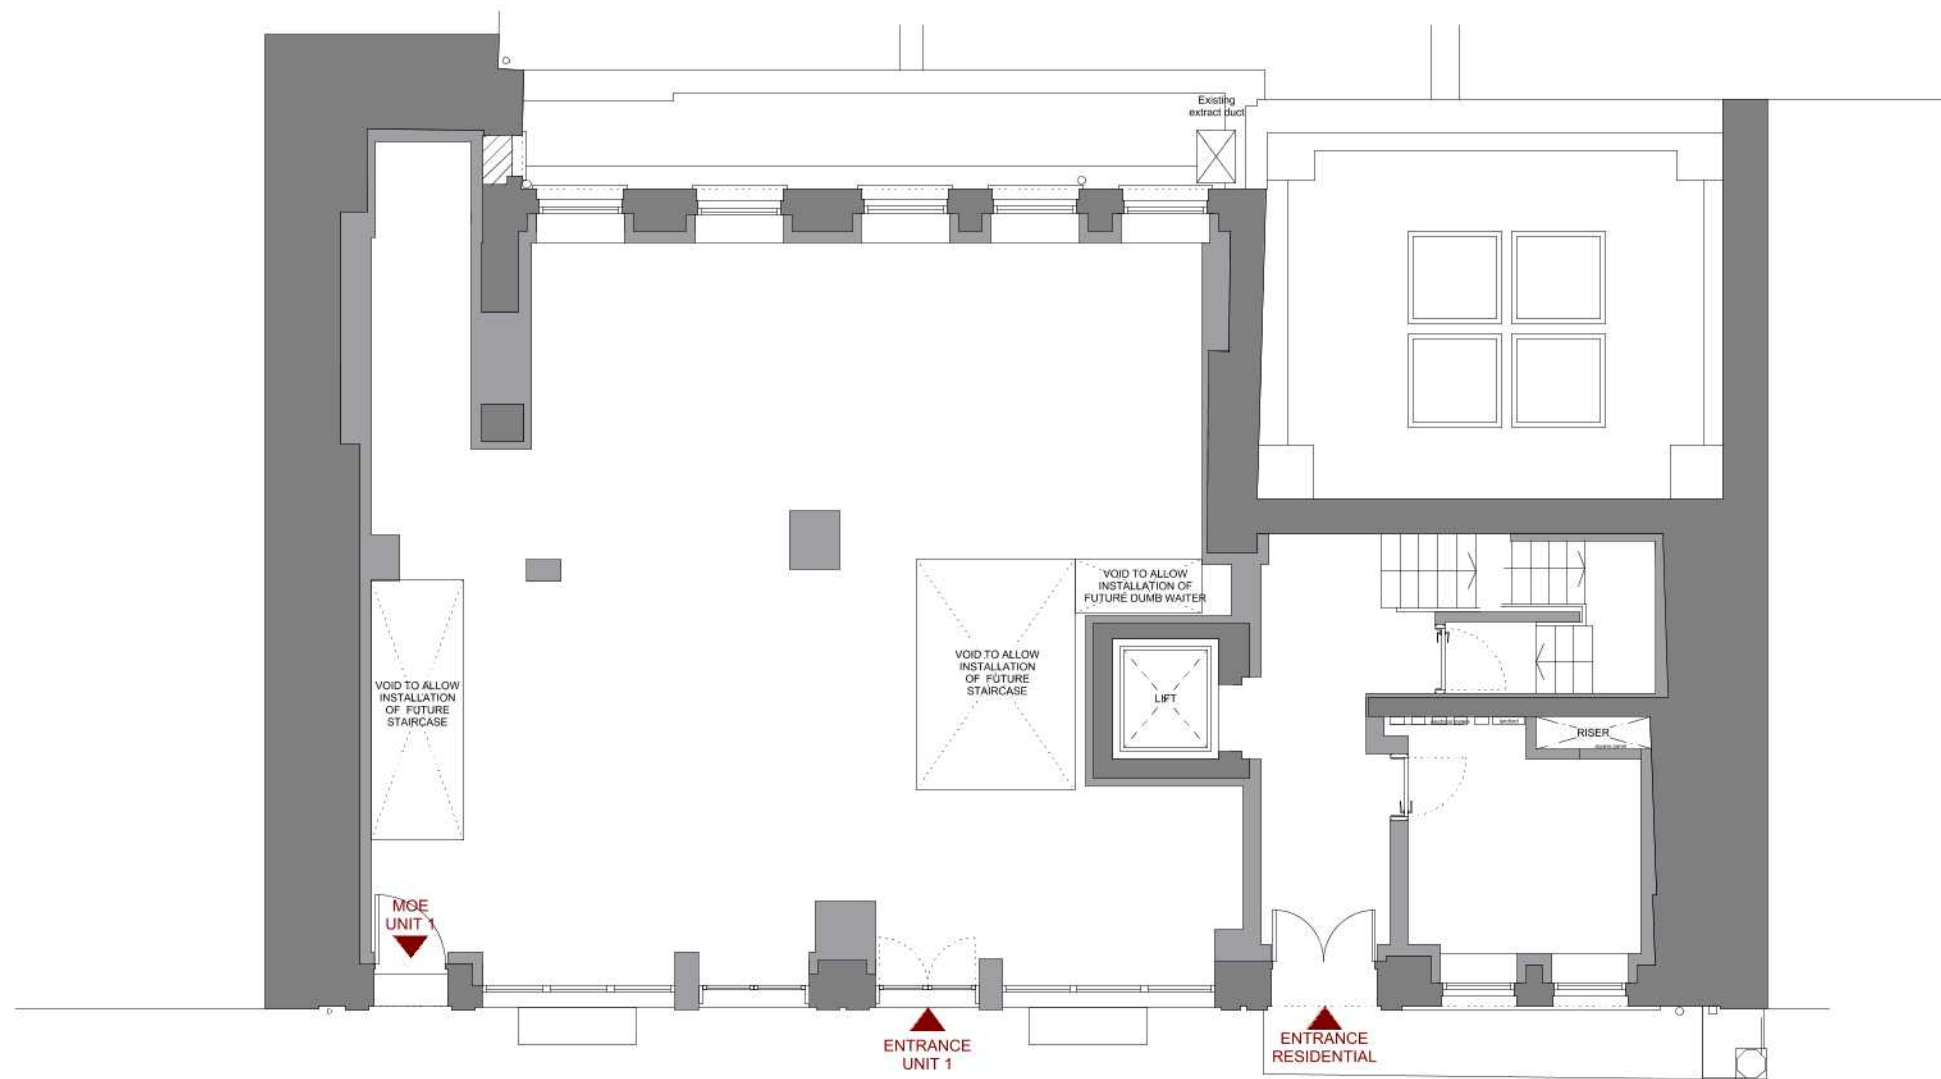

Disclaimer:
 This plan is for layout guidance only. Not drawn to scale, unless stated.
 Measured & drawn to the nearest 15cm / 6 inches.
 Whilst every care is taken in the preparation of this plan, please check all dimensions, shapes & compass bearings before making any decisions reliant upon them.
 The external elements that are shown are drawn to provide context but should not be used for any other purpose. Do not use this drawing to reference structure or mechanical services.

NOTES:
 · DO NOT SCALE FROM THIS DRAWING.
 · ALL DIMENSIONS TO BE CHECKED ON SITE.
 · ALL OMISSIONS AND DISCREPANCIES TO BE REPORTED TO THE ARCHITECT IMMEDIATELY

DRAWING TITLE		LEVEL 0_AS BUILTS GENERAL ARRANGEMENT_ANNOTATION PLAN			
DATE	01.2018	SCALE	1:100 @ A3	JOB NO.	449
DRWG NO.	AB.101	REV.			